


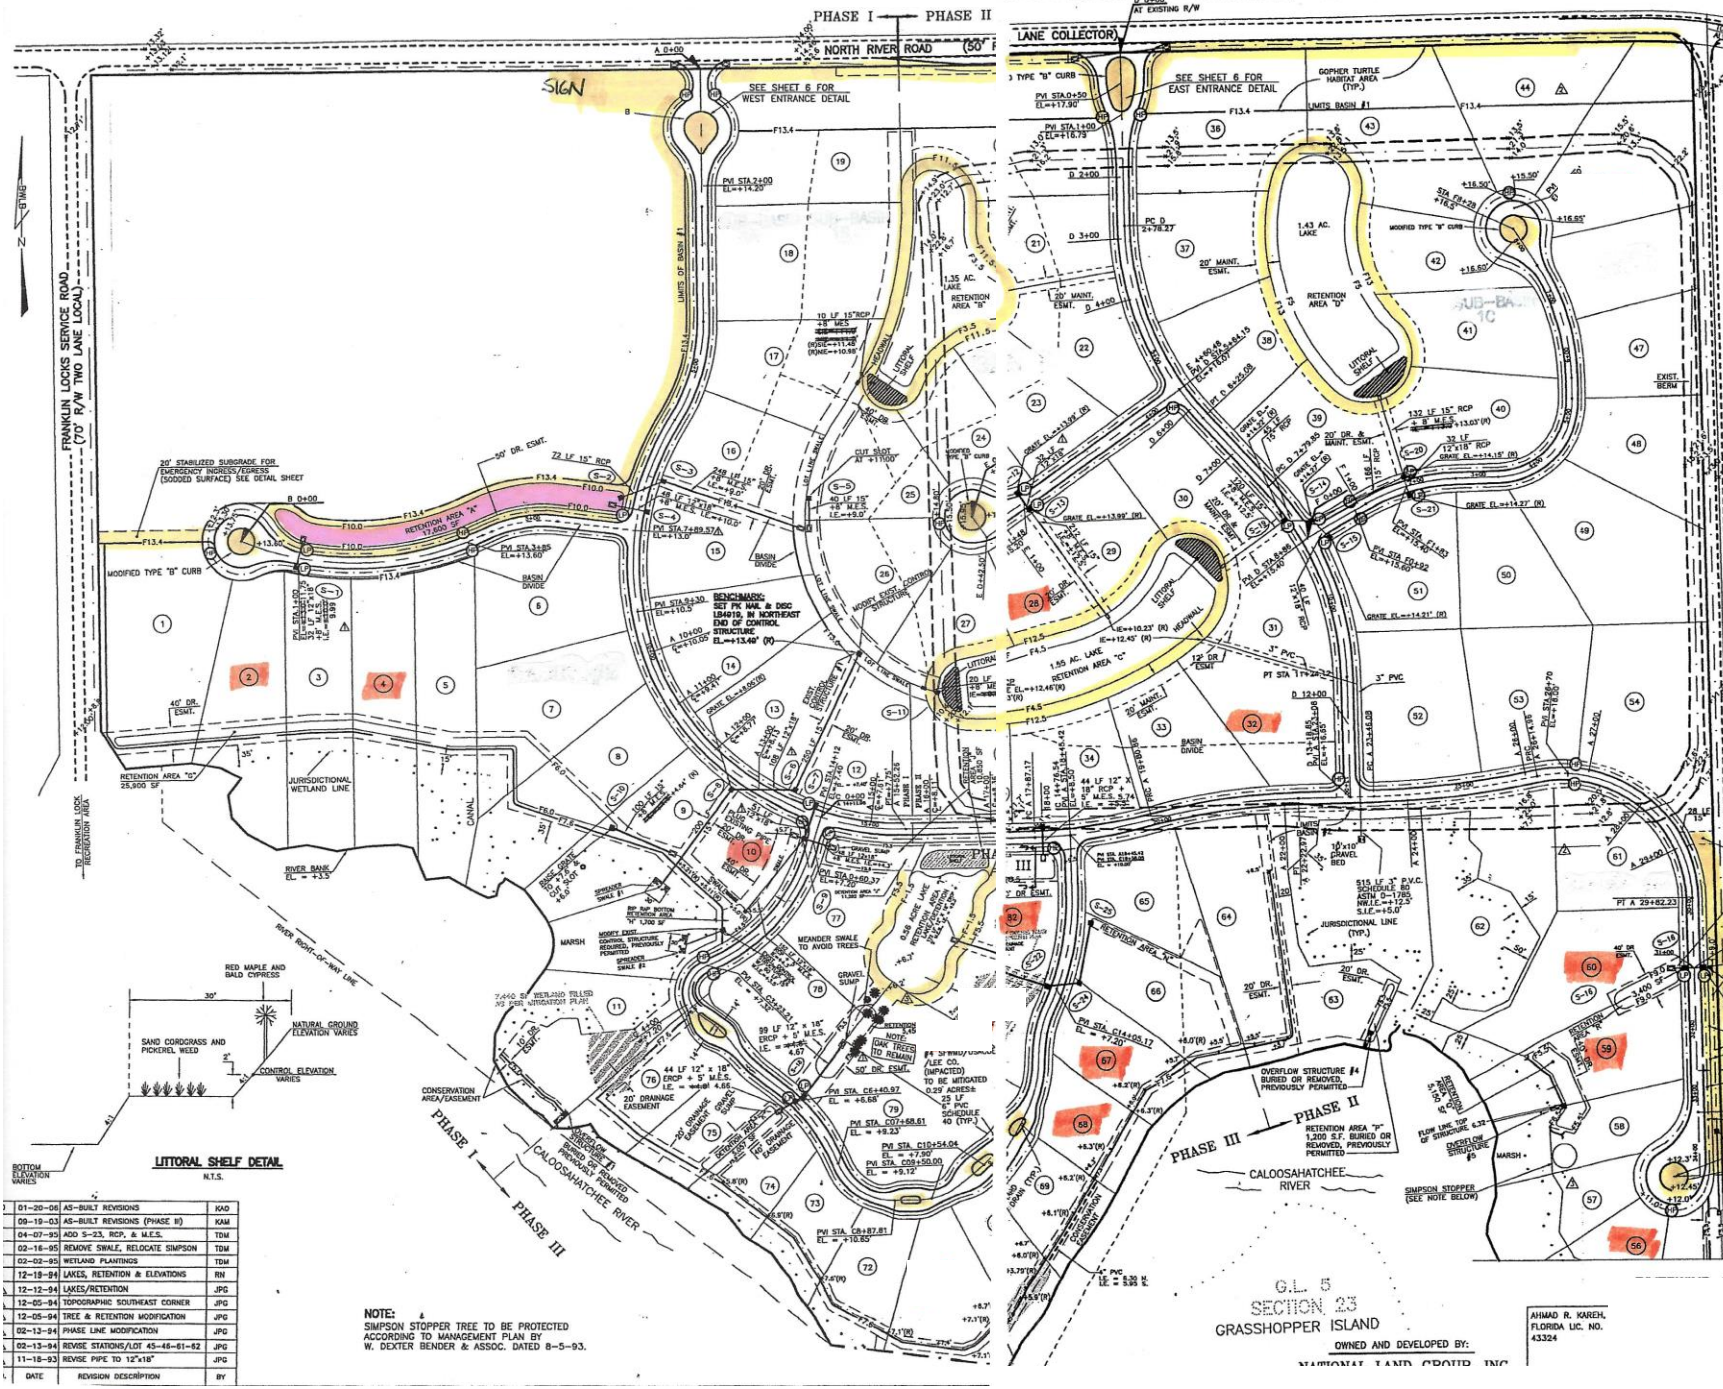

DATE	REVISION DESCRIPTION	BY
01-29-06	AS-BUILT REVISIONS	KAD
06-19-03	AS-BUILT REVISIONS (PHASE II)	KAM
04-07-95	ADD S-23, RCP, & M.E.S.	TDM
02-16-95	REMOVE SWALE, RELOCATE SIMPSON	TDM
02-02-95	WETLAND PLANTINGS	TDM
12-18-94	LAKE, RETENTION & ELEVATIONS	RH
12-12-94	LAKE/RETENTION	JPC
12-09-94	TOPOGRAPHIC SOUTHWEST CORNER	JPC
12-05-94	TREE & RETENTION MODIFICATION	JPC
02-13-94	PHASE LINE MODIFICATION	JPC
02-13-94	REVERSE STATIONS/LOT 45-46-61-62	JPC
11-18-93	REVERSE PIPE TO 12"x18"	JPC

NOTE:
SIMPSON STOPPER TREE TO BE PROTECTED
ACCORDING TO MANAGEMENT PLAN BY
W. DEXTER BENDER & ASSOC. DATED 8-5-93.

G.L. 5
SECTION 23
GRASSHOPPER ISLAND

OWNED AND DEVELOPED BY:
MARSHALL LAND, CROFT, INC.

AHMAD R. KAREH,
FLORIDA LIC. NO.
43324